



RECORD DRAWING
December 14, 2010
Revised

* DENOTES ACTUAL PIPE LENGTH (STRUCTURE TO STRUCTURE). FOR PAID PLAN QUANTITY, SEE STATION NOTE.

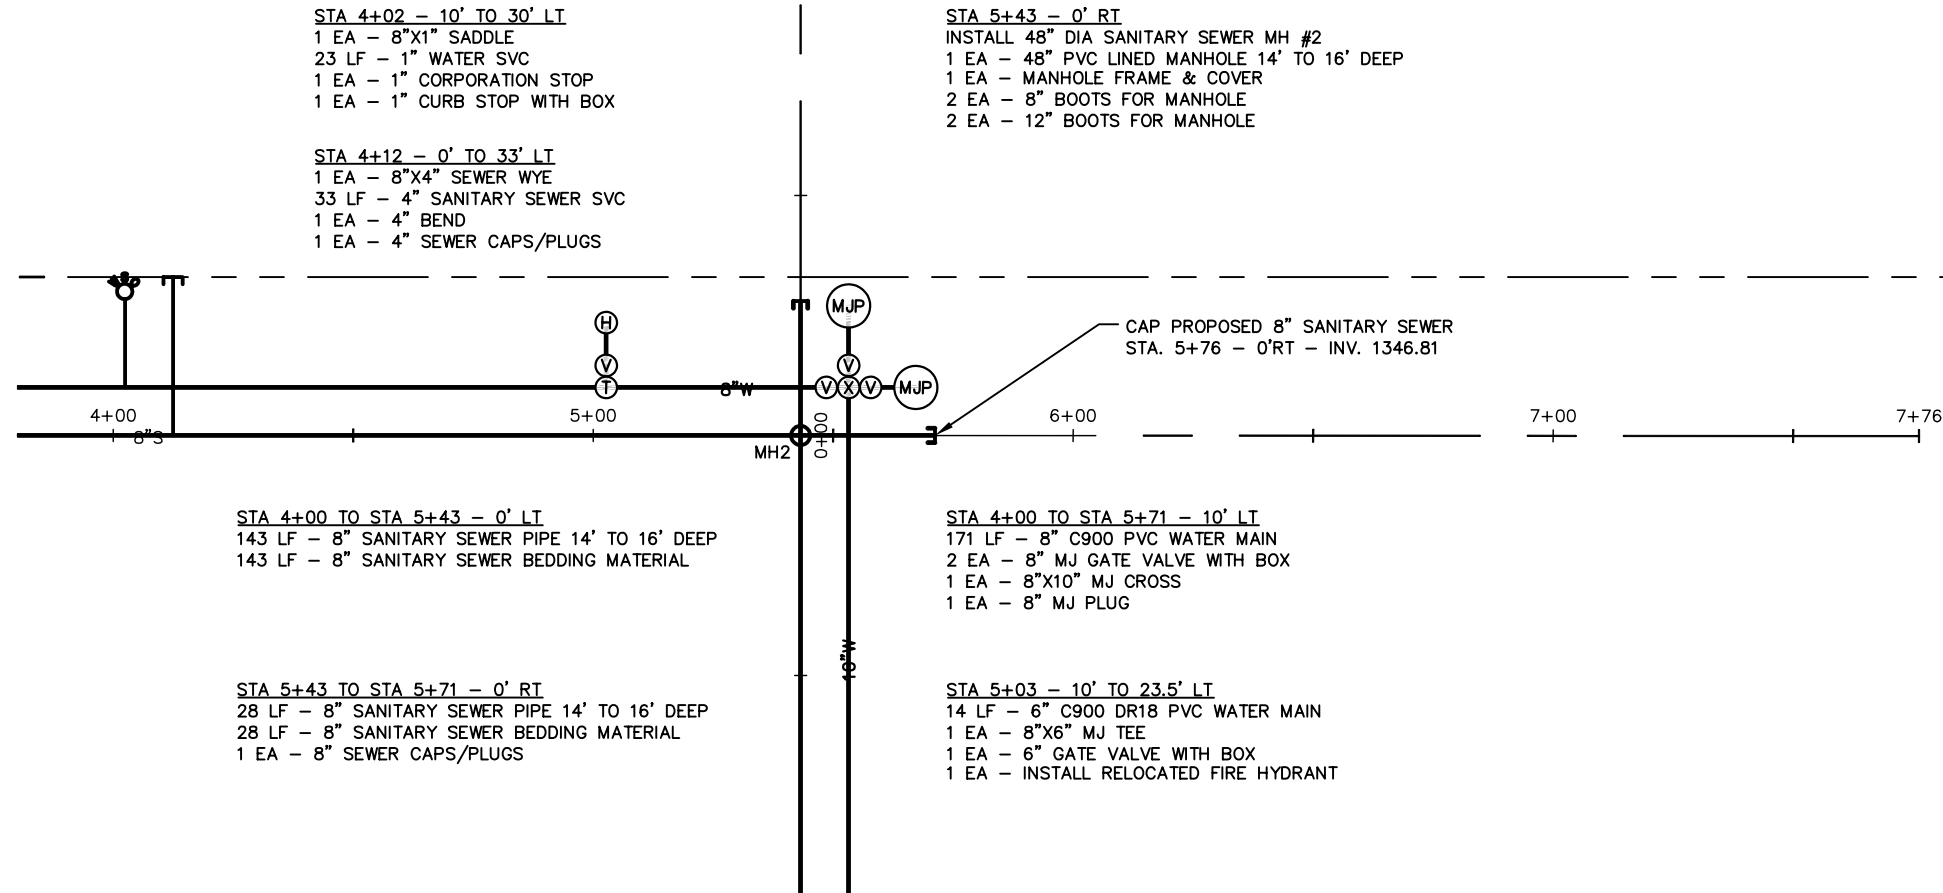

STA. 5+43.22=0.00'RT
MH #2 (14.40' DEEP)
RIM - 1361.00
INV.(W)(8") - 1346.70
INV.(E)(8") - 1346.70
INV.(N)(12") - 1346.70
INV.(S)(12") - 1346.60

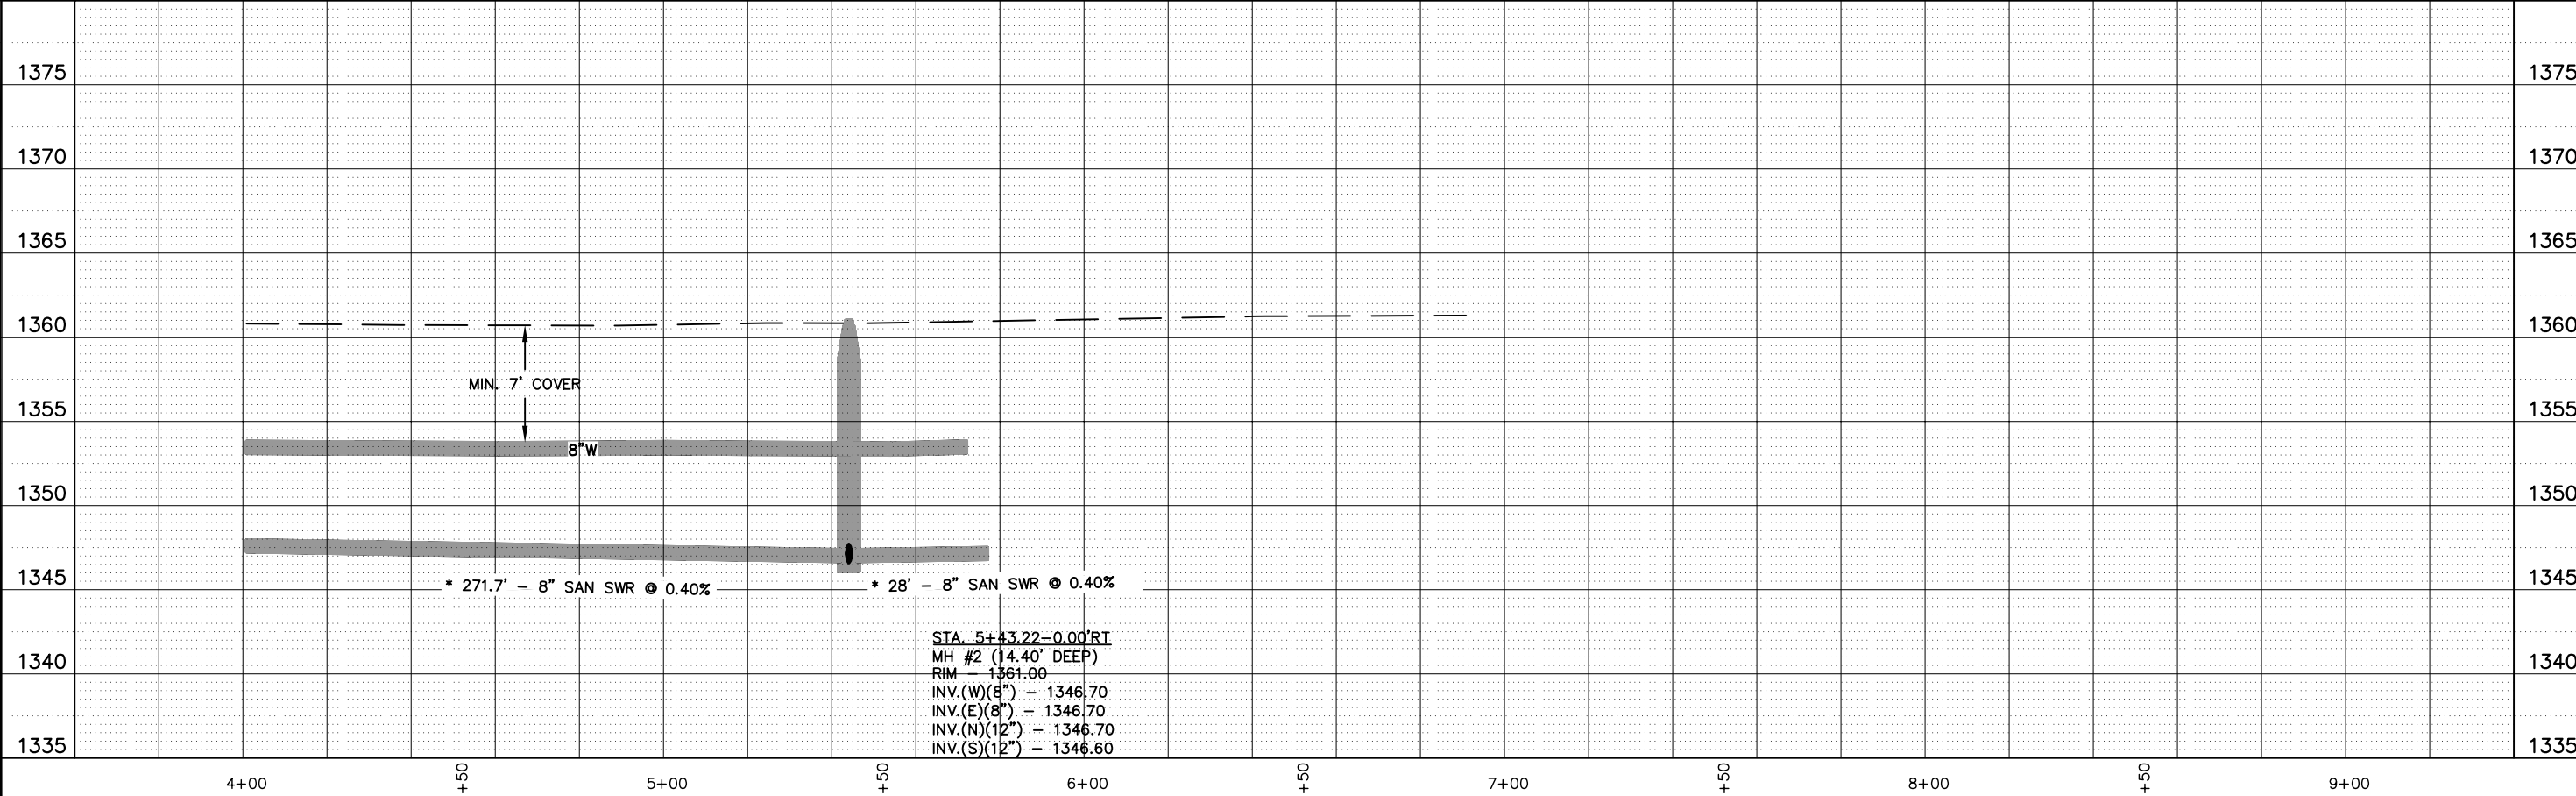